


圖斷縱面計立埋

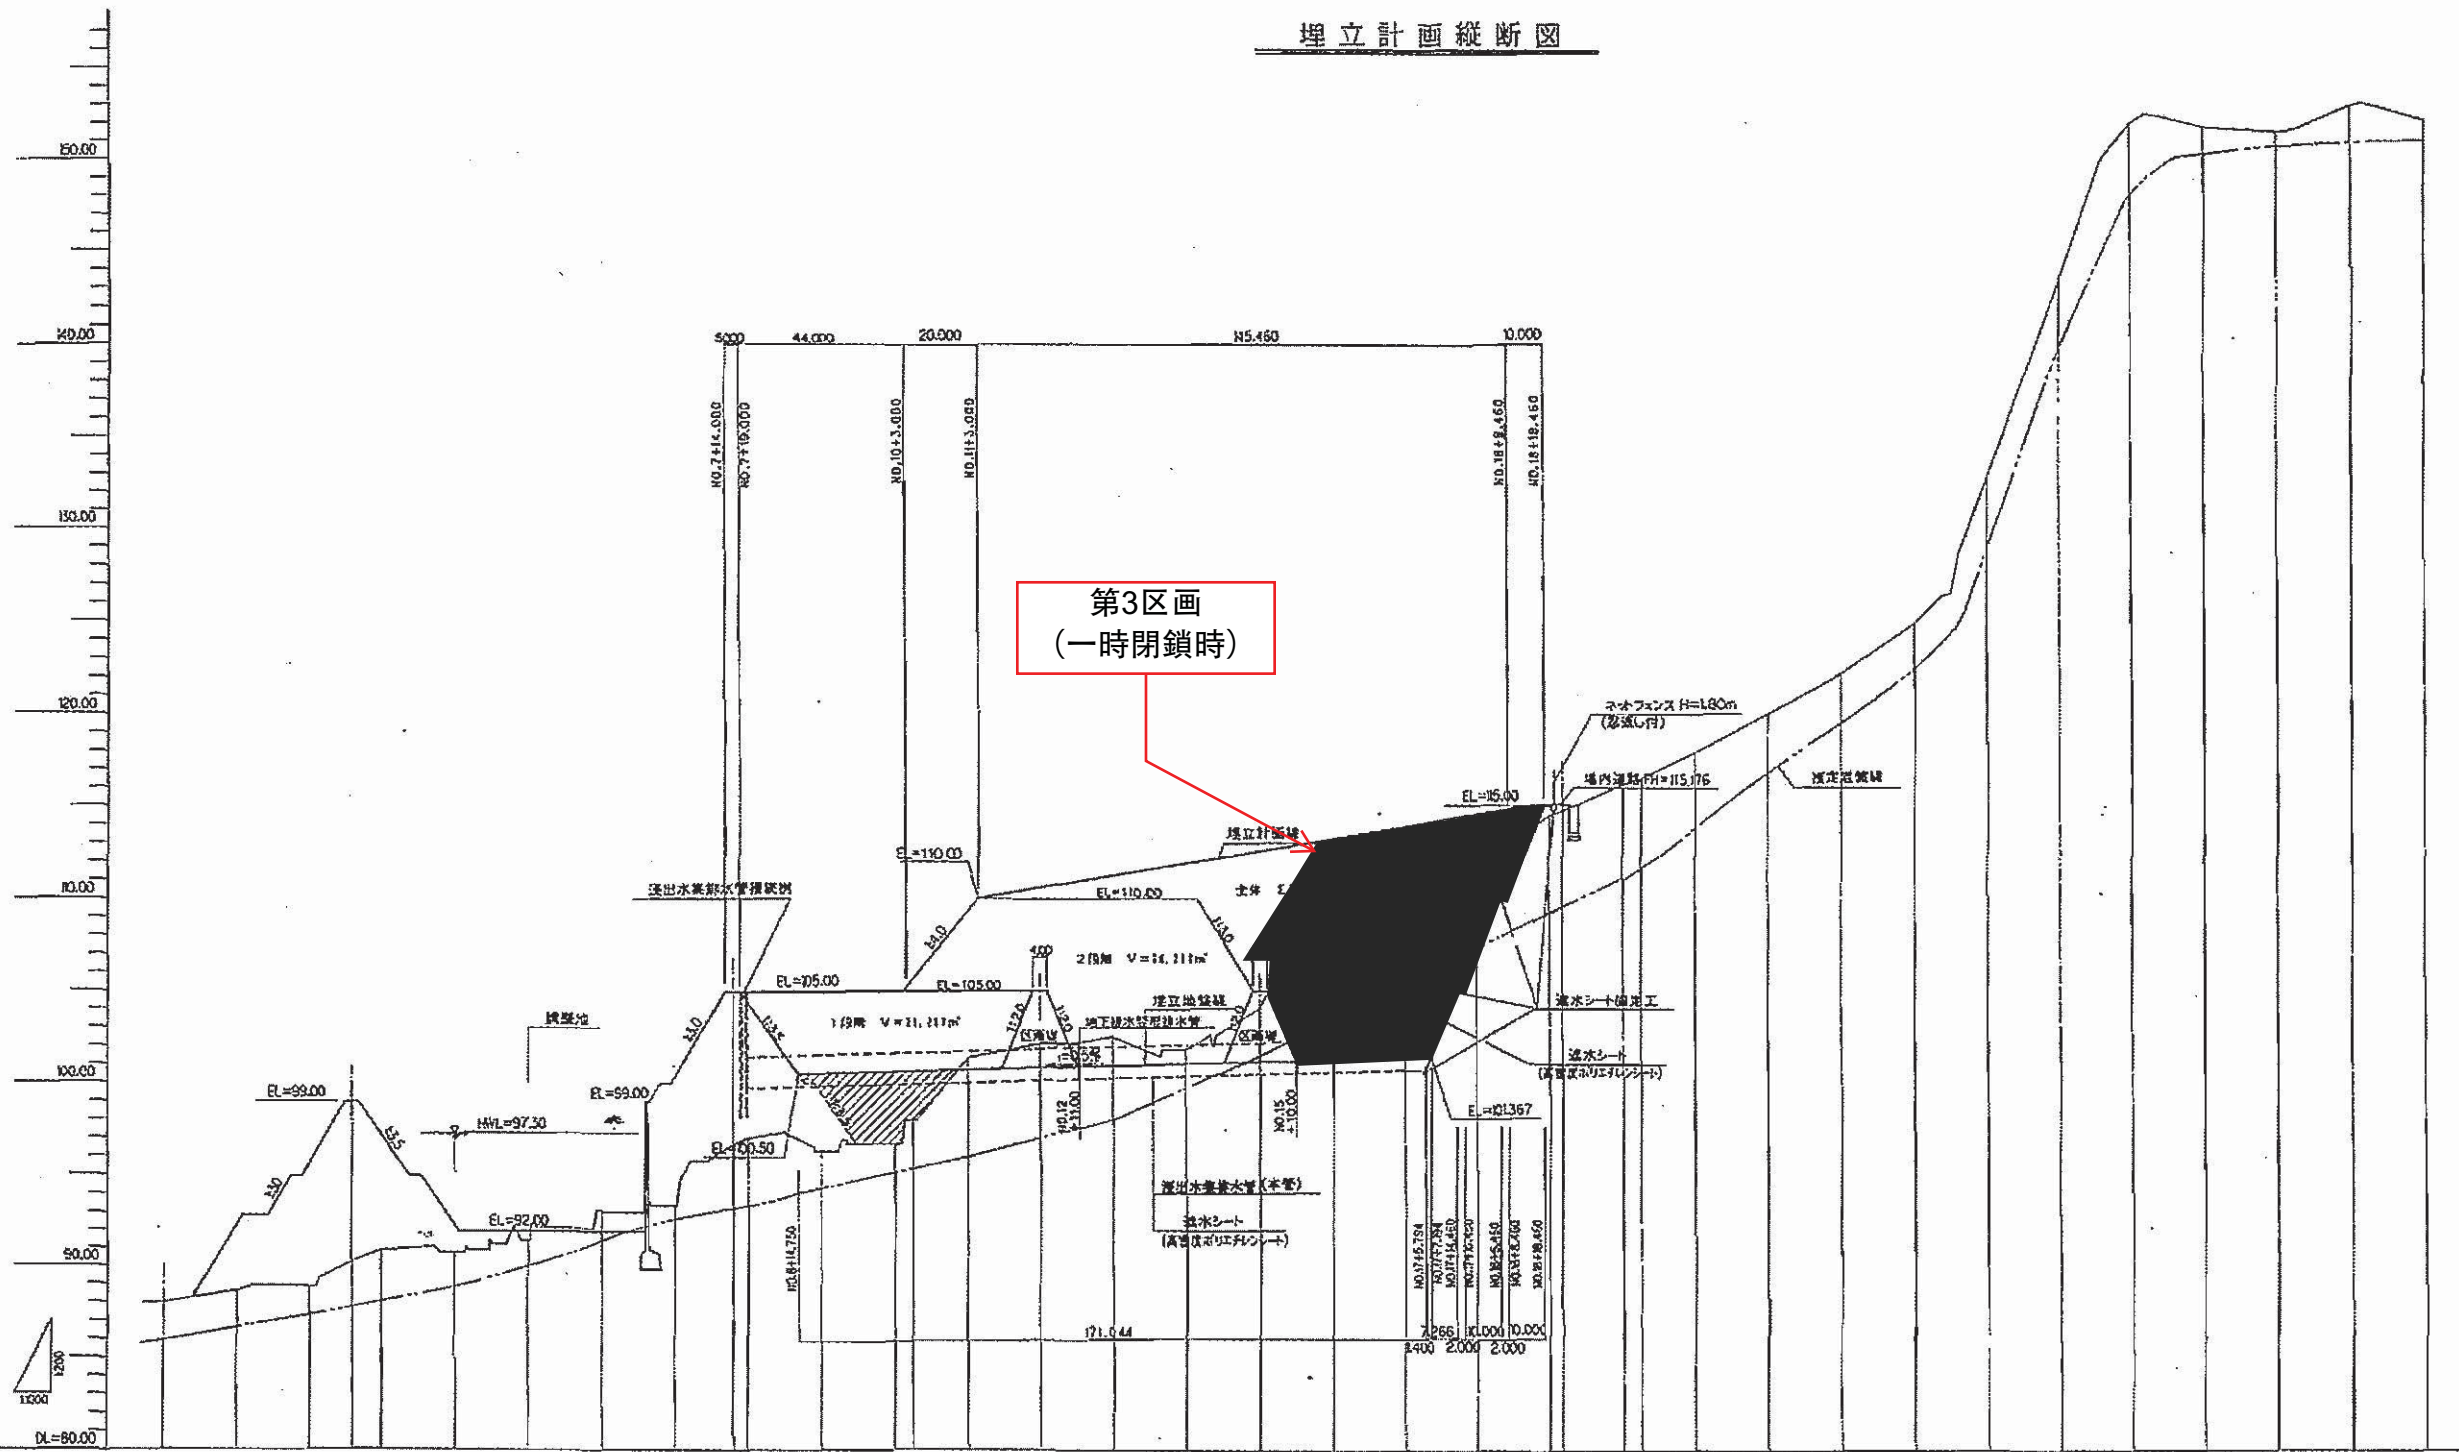

編號	承造廠	原估價值	核准預算	切實	備註
No. 0	0.000	0.000	88.00	0	
No. 1	20.000	20.000	88.70	52.333	5.633
No. 2	20.000	40.000	89.00	95.667	6.667
No. 3	12.000	92.000	90.40	99.000	8.600
No. 4	8.000	80.000	91.00	97.286	6.286
No. 5	20.000	80.000	90.65	92.432	1.572
No. 6	20.000	100.000	91.45	92.000	0.550
No. 7	20.000	120.000	93.01	92.000	1.010
No. 8	20.000	140.000	93.41	100.353	6.950
No. 9	20.000	160.000	95.70	105.000	9.300
No. 10	20.000	180.000	96.80	104.714	7.914
No. 11	20.000	200.000	98.00	109.538	2.538
No. 12	20.000	220.000	101.40	108.728	0.672
No. 13	20.000	240.000	102.10	100.831	1.269
No. 14	20.000	260.000	102.50	100.931	1.569
No. 15	20.000	280.000	101.60	101.031	0.789
No. 16	20.000	300.000	104.05	101.131	2.665
No. 17	20.000	320.000	106.50	101.231	7.265
No. 18	20.000	340.000	110.90	101.331	9.565
No. 19	20.000	360.000	112.40	101.500	4.800
No. 20	20.000	380.000	114.20	115.216	0.716
No. 21	20.000	400.000	116.20	115.176	0.576
No. 22	20.000	420.000	116.20		
No. 23	20.000	440.000	116.50		
No. 24	20.000	460.000	117.20		
No. 25	20.000	480.000	124.90		
No. 26	20.000	500.000	132.70		
No. 27	20.000	520.000	143.50		
No. 28	20.000	540.000	151.90		
No. 29	20.000	560.000	151.70		
No. 30	20.000	580.000	151.40		
No. 31	20.000	600.000	152.20		

竣工图

件名	仙南最北処分場建設工事		
箇所	白石市野山字黒岩地内		
工事名	平成 年度	工事	
図名	埋立計画断面図		
縮尺	図示	位置	
設計者		延原 亮	
仙南地成広域行政事務組合	図番	2-32	